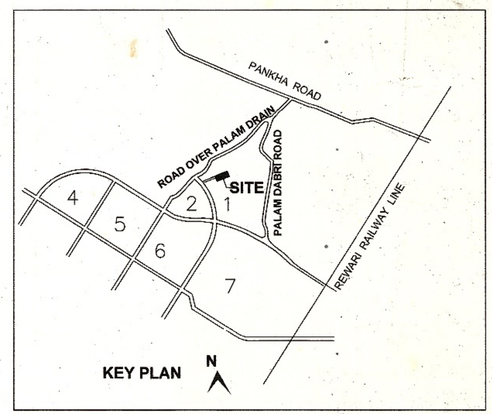

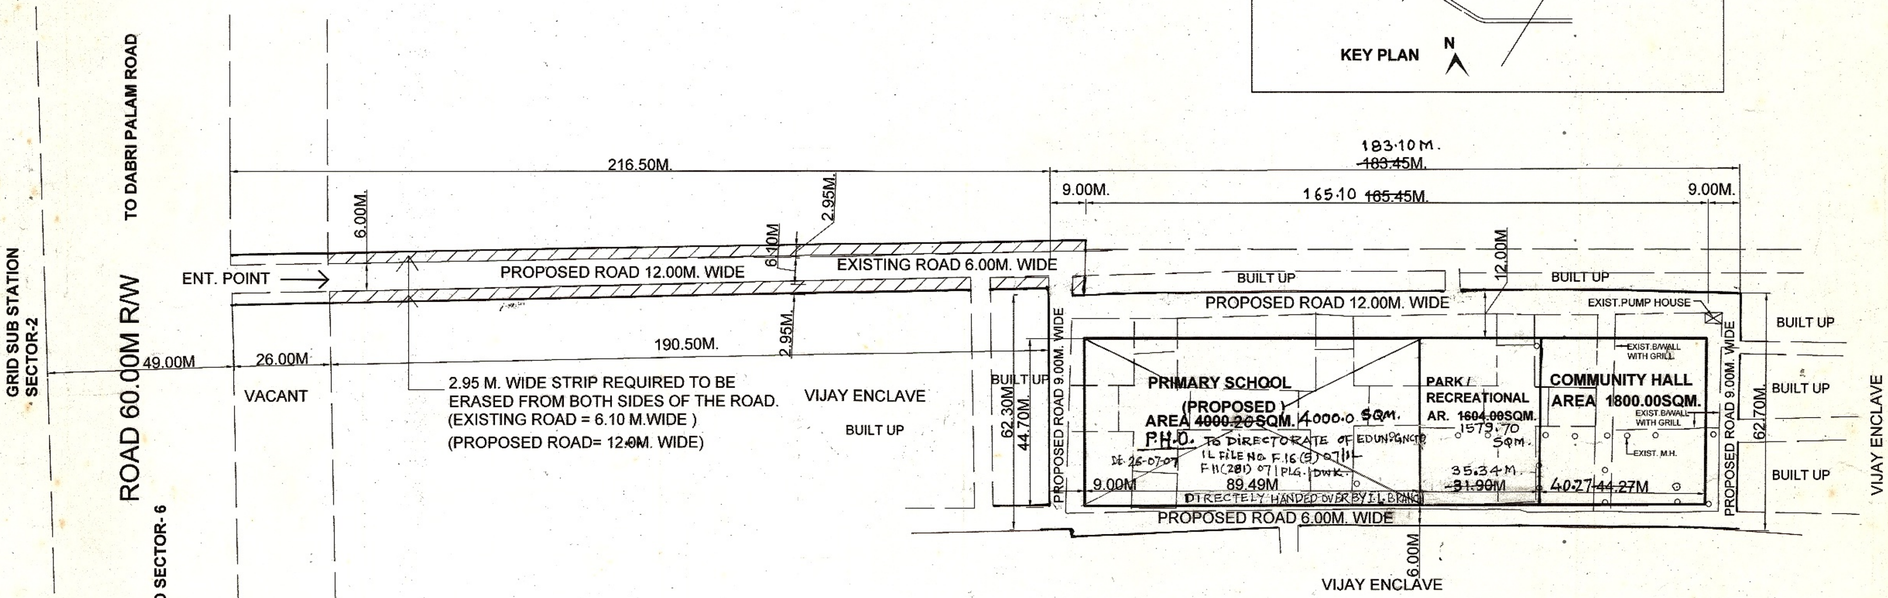

THE SCHEME WAS DISCUSSED IN THE 251ST SCREENING COMMITTEE MEETING HELD ON 13.10.2006 VIDE ITEM NO. 109:2006.THE PROPOSAL AS REFLECTED IN THE AGENDA WAS APPROVED.

THE APPROVAL OF 251ST SCREENING COMMITTEE MEETING DT. 13-10-06, HAS BEEN CERTIFIED BY DIR.(PLG.) DWARKA AND VERIFIED BY DY. DIR.(ARCH.) CO-ORDINATION ON DT. 6-12-06 VIDE FILE NO. F1(351) 97/DWK.
14-12-06

D . D. A.

DWARKA PROJECT

PROPOSAL

TOTAL AREA OF POCKET = 11400 SQM.

PROPSED AREA FOR

PRIMARY SCHOOL	= ~~4000~~ 4000.20 SQM.
COMMUNITY HALL	= 1800 SQM.
PARK/RECREATIONAL	= ~~1604~~ 1579.70 SQM.
AREA UNDER CIRCULATION	= ~~3996~~ 4020.10 SQM.
	TOTAL = 11400 SQM.

NOTES :

1.THIS DRG. HAS BEEN PREPARED ON THE BASIS OF P.T. SURVEY OF PKT 5A NEAR VIJAY ENCLAVE,VIDE SURVEY DRG. NO. 201/2005 DATED 27-6-05.

2. THE LAND DISPOSAL DEPARTMENT WILLTAKE FURTHUR ACTION FOR ESTABLISH THE OWNERSHIP OF LAND AND FURTHER ALLOTMENT OF LAND.

3. THE EXISTING DEVELOPMENT AT THE PREVIOUS APPROVED L.O.P. HAS BEEN REPORTED BY THE SWD-8 VIDE DY.NO.152DATED 1-6-06.

4. WRITTEN DIMENSIONS ARE TO BE FOLLOWED.

5. FEASIBILTY HAS BEEN INCORPORATED AS PER FEASIBILTY REPORT GIVEN BY E.E|WD-9|DWK AT PAGE NO. 1|C AND 3|N IN THE FILE NO.F23A(36)07|IL.

LAYOUT PLAN

PROPOSED COMMUNITY HALL / BARATGHAR IN ISOLATED POCKET 5-A NEAR MIRZAPUR DWARKA

SCALE : 1: 500	DRG. NO.		
B.NAND SHARMA PLG. D/MAN	PLG. ASSTT.	DATE	N NORTH
ASSTT. DIR. (PLG.)	JT. DIRECTOR (PLG)	DIRECTOR (PLG.)	

DELHI DEVELOPMENT AUTHORITY